

## **PART 1 - TAB AGENCY**

1. General:
  1. The basic testing and balancing shall be provided by Division 23 and in accordance with this Section.
  2. The independent TAB Agency employed and paid by Division 23 will be providing the final testing and balancing.
  3. Division 1, General Requirements is part of this Section and shall apply as if repeated here.
2. Quality assurance:
  1. TAB to be performed to standards of ASHRAE.
3. Co-ordination:
  1. Co-ordinate all work specified in this Section.
  2. Provide all facilities required by TAB Agency in order to carry out work of this Section.
4. Adequacy of work for TAB:
  1. TAB Agency to review contract documents before work is started and confirm in writing to Consultant adequacy of provisions for TAB and all other aspects of installation pertinent to TAB.
  2. Division 23 shall provide equipment commissioning and preliminary balancing and confirm the proper operation of all systems.
5. List of TAB Agencies:
  1. ABG Air Balance Group  
(416) 283-0637
  2. Aerodynamics Inspecting Consultants Ltd.  
(905) 625-4388
  3. Design Test Balance  
(905) 886-6513

## **PART 2- GENERAL**

1. TAB: means to test, adjust and balance all systems to perform in accordance with Contract Documents.
2. Follow start-up procedures as recommended by manufacturer unless otherwise specified.

3. Special start-up procedures may be specified elsewhere.
4. Notify Consultant 7 days prior to start of TAB.
5. Operate all systems to permit TAB to be performed.
6. TAB to apply to systems, equipment and related controls specified in Division 23.
7. Reference organization standards:
  1. Do TAB over entire operating range in accordance with most stringent conditions of this specification and standard of following organization.
8. Alternate season testing to be provided by TAB Contractor where applicable.
9. TAB Contractor to inspect site during construction in order to assure that all balancing devices are installed properly and in pre-selected locations.
10. Mechanical contractor to provide the TAB contractor with all related approved shop drawings and change notices.
11. Start TAB only when building is essentially completed, including:
  1. Installation of ceilings, doors, windows and other construction affecting TAB.
  2. Application of sealing, caulking and weatherstripping.
  3. All pressure, leakage and other tests specified elsewhere in Div. 23 completed.
  4. All provisions for TAB are installed and operational.
12. Start-up, verification for proper, safe and normal operation of mechanical and associated electrical and control systems affecting TAB including, but not limited to, the following:
  1. Proper thermal overload protection in place for electrical equipment.
  2. Air Systems:
    1. Filters in place and in clean condition.
    2. Duct systems clean of debris.
    3. Air shafts, ceiling plenums are airtight to within specified tolerances.
    4. Correct fan rotation.
    5. Fire and volume dampers in place and open.
    6. Coil fins cleaned and combed.
    7. Access doors closed and duct end caps in place.

8. All outlets installed and connected.
13. Accuracy tolerances:
  1. Do TAB to following tolerances of design values:
    1. HVAC systems: Plus 5%; minus 5%.
    2. As original tolerances.
    3. Measurements to be accurate to within plus or minus 2% of actual values.
  2. Instrument calibration: to be in accordance with TAB referenced organization standard, but within 3 months of commencement of TAB.
14. Submittals prior to commencement of TAB:
  1. Proposed methodology and procedures for performing TAB.
  2. Proposed check lists and report forms.
  3. List of instrumentation, including details and certificates of calibration.
15. Report:
  1. Format to be in accordance with TAB referenced organization standard, but using SI units.
  2. Report to include as built full system schematics showing results of TAB.
  3. Submit, prior to formal submission of TAB reports, for checking and approval by Consultant, sample of rough TAB sheets. Include:
    1. Details of instruments used.
    2. Details of TAB procedures employed.
    3. Calculations procedures.
    4. Summaries.
  4. Submit 3 copies of TAB reports, each in "D" ring binders, complete with index tabs for verification and approval of Consultant.
16. Verification:
  1. Reported measurements shall be subject to verification by Consultant. Provide instrumentation and manpower to verify results of up to 30% of all reported measurements. Number and location of verified measurements to be at discretion of Consultant.


2. Bear costs to repeat TAB, as required, to satisfaction of Consultant.
  1. Settings: lock and permanently mark settings as required by reference standard.
  2. Completion: TAB to be considered complete only when final reports are approved by Consultant.

### **PART 3- AIR MOVING SYSTEMS**

1. General: measurements as required by referenced organization standards, including, but not limited to, following:
  1. Measurements:
    1. Air velocity.
    2. Static pressure.
    3. Velocity pressure.
    4. Temperature:
      1. Dry bulb.
    5. Cross sectional area.
    6. RPM.
    7. Electrical power:
      1. Voltage
      2. Current draw.
  2. Location of equipment measurements:
    1. Inlet and outlet of each:
      1. Fan.
      2. Coil.
      3. Filter.
      4. Damper.
      5. Humidifiers.
      6. Terminal Units.
      7. Other auxiliary equipment.

3. Location of system measurements at:
  1. Main ducts.
  2. Main branch ducts.
  3. Sub-branch ducts.
  4. Each supply, exhaust and return air inlet and outlet.
  5. Other auxiliary equipment.
  6. All areas served by system.
  7. Each thermostatically controlled zone.

END OF SECTION 23 05 93

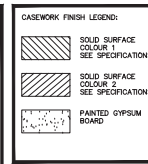

EXISTING GYPSUM AND STUD FRAMING TO REMAIN

19mm PLYWOOD

CONTINUOUS WOOD BLOCKING

GLASS MOUNTING COMPONENT

140 140

Date	Description
27.8.2025	ISSUED FOR ADDENDUM
25.13.2025	ISSUED FOR TENDER

Do not scale from this drawing. The Constructor shall verify all actual on site dimensions and report any discrepancies to the Consultant prior to proceeding with the work.



ONTARIO ASSOCIATION  
OF  
ARCHITECTS  
*Ian Hill*  
LICENCE  
6888

CRITCHLEY HILL  
ARCHITECTURE  
CRITCHLEY HILL ARCHITECTURE INC.  
NORTH BAY OAKLAND 705.992.2391 CRITCHLEYHILL.CA

1

BUS TERMINAL BARRIER FREE ACCESS	
-------------------------------------	--


Project: <b>ONTARIO NORTHLAND          RENOVATIONS AND BA          100 STATION RD          NORTH BAY ONTARIO</b>	Drawing Title: <b>RENOVATION FLOOR PLAN          DEMOLITION FLOOR PLAN          INTERIOR ELEVATIONS          PLAN &amp; SECTION DETAILS</b>
	Drawn By: ES
Scale: 1:50	Project No: 2353

Date Plotted:  
July 8, 2025


Date Revised:  
April 3, 2025

Drawing No:  
100


**AD1.02**

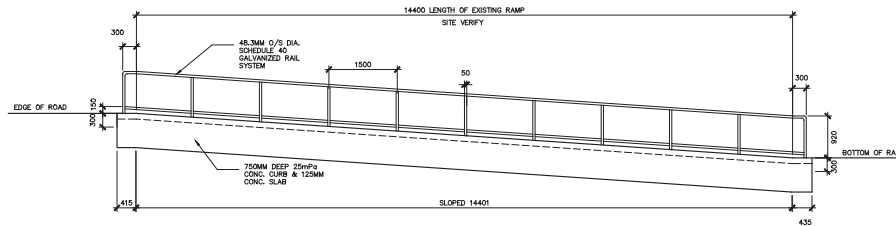

3 NEW HANDRAIL ELEVATION  
A3.00 SCALE 1:20

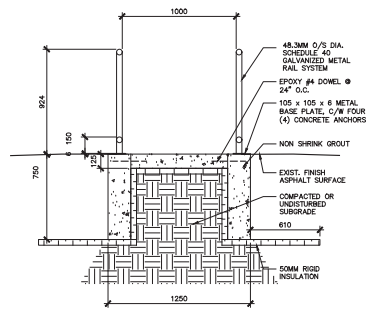

4 NEW RAILING SECTION  
A3.00 SCALE 1:20

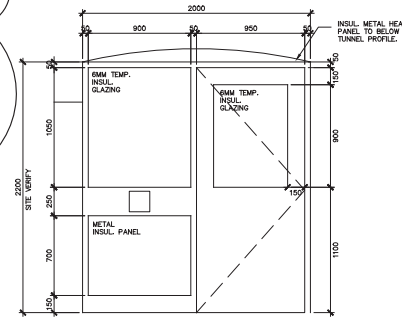

5 NEW DOOR  
A3.00 SCALE 1:20

#### HARDWARE LIST

- 8101 - 1 DOOR POWER OPERATOR
- 8102 - ADJUST EXISTING DOOR OPERATOR
- 8103 - 1 CONTINUOUS HINGE
- 1 DOOR POWER OPERATOR
- 1 EXIT DEVICE
- 1 SET WEATHER STRIPPING
- 1 THRESHOLD

- DOOR B103
- INSUL. H.M. FRAME
- 146 THROAT SIZE
- INSUL. H.M. DOOR
- INSUL. METAL PANEL.
- TEMP.
- 6 MIL INSUL.
- DOUBLE GLAZING

AD1

Project No.	2583
Client	ONTARIO NORTH LAND BUS TERMINAL
Location	1000 HWY 401, NORTH BAY, ONTARIO
Drawn By	AE
Checked By	AE
Date	July 24, 2025

Do not scale from this drawing. The Constructor shall verify all actual on site dimensions and report any discrepancies to the Consultant prior to proceeding with the work.




**CRITCHLEY HILL**  
ARCHITECTURE  
CRITCHLEY HILL ARCHITECTURE INC.  
NORTH BAY OFFICE 705.332.2387 OFFICE@CHILL.CA


Project: **ONTARIO NORTH LAND BUS TERMINAL**  
COUNTERTOP, BARRIER FREE ACCESS, & WASHROOM UPGRADES  
1000 HWY 401, NORTH BAY, ONTARIO  
Drawing Title: **DOOR AND HANDRAIL DETAILS**  
HANDRAIL DET

Drawn By	AE
Checked By	AE
Scale	1:100
Project No.	2583
Date Plotted	July 24, 2025
Date Revised	January 3, 2024

Drawing No. **AD3.00**

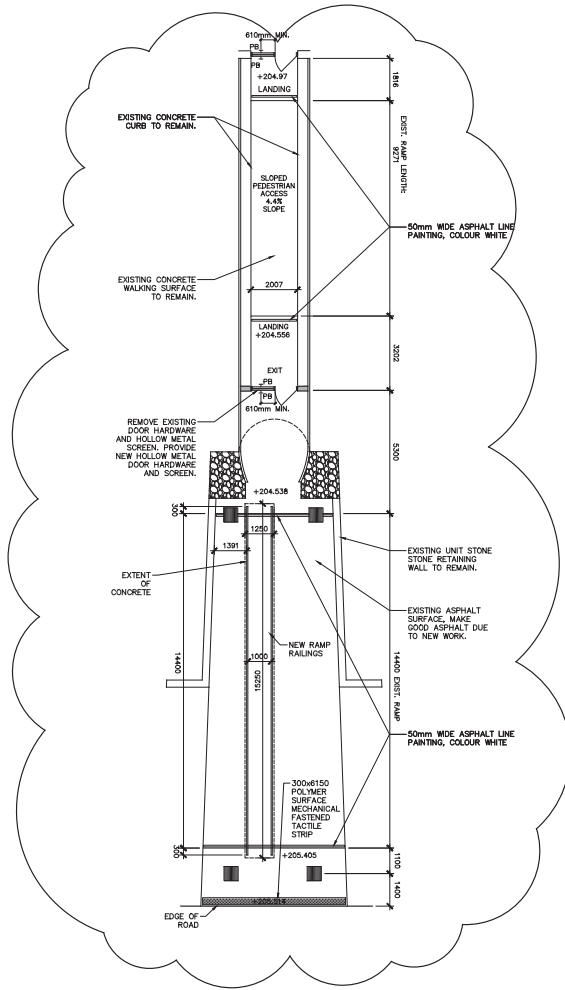

2 EXIT TUNNEL PLAN  
SCALE 1:100

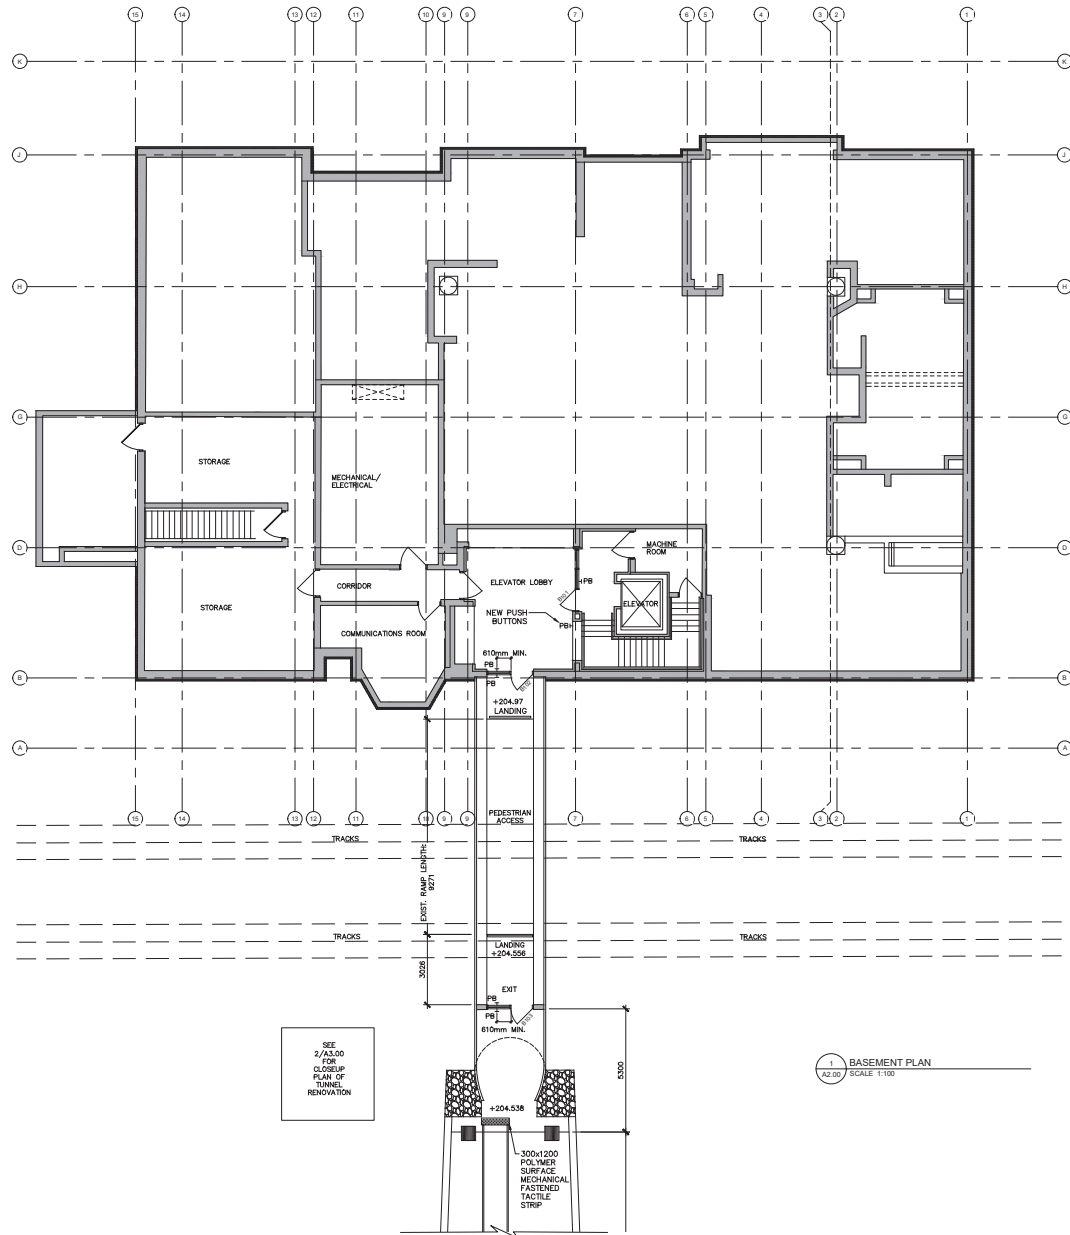

1 BASEMENT PLAN  
SCALE 1:100

Project No.	23-12-2023
Client	CRITCHLEY HILL ARCHITECTURE INC.
Design Team	CRITCHLEY HILL ARCHITECTURE INC.
Drawn By	AE
Checked By	AE
Date	23-12-2023
Scale	1:100
Project No.	2383

Do not scale from this drawing. The Constructor shall verify all actual on site dimensions and report any discrepancies to the Consultant prior to proceeding with the work.



CRITCHLEY HILL  
ARCHITECTURE  
ARCHITECTURE  
CRITCHLEY HILL ARCHITECTURE INC.  
NORTH BAY ONTARIO L0S 1B1 CANADA

Project	ONTARIO NORTHLAND BUS TERMINAL NORTH BAY ONTARIO NORTH BAY ONTARIO NORTH BAY ONTARIO
Drawn By	AE
Checked By	AE
Date Plotted	July 9, 2025
Date Revised	January 5, 2024
Drawing No.	AD2.00